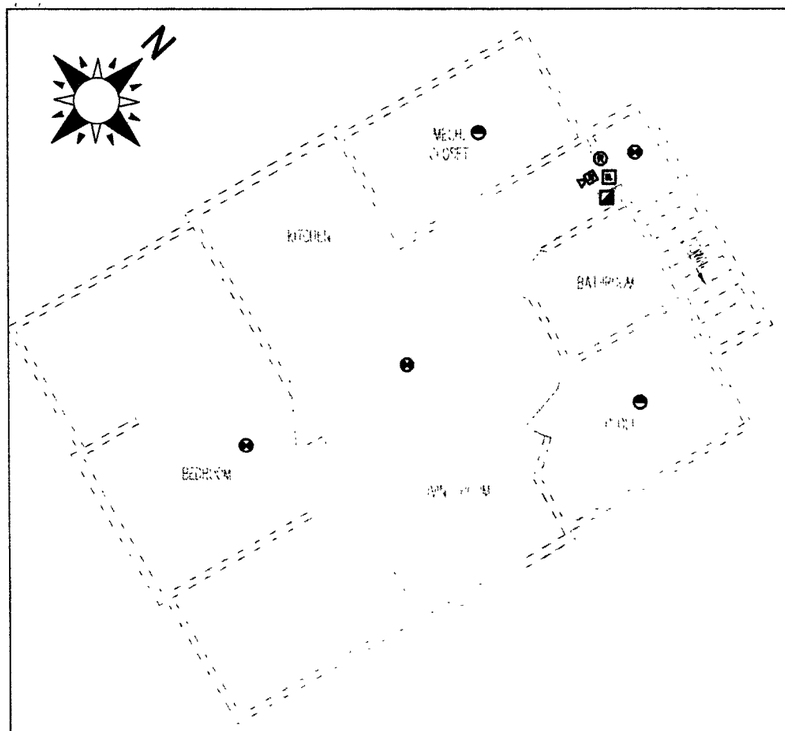

2 SECOND FLOOR LAYOUT
NTS

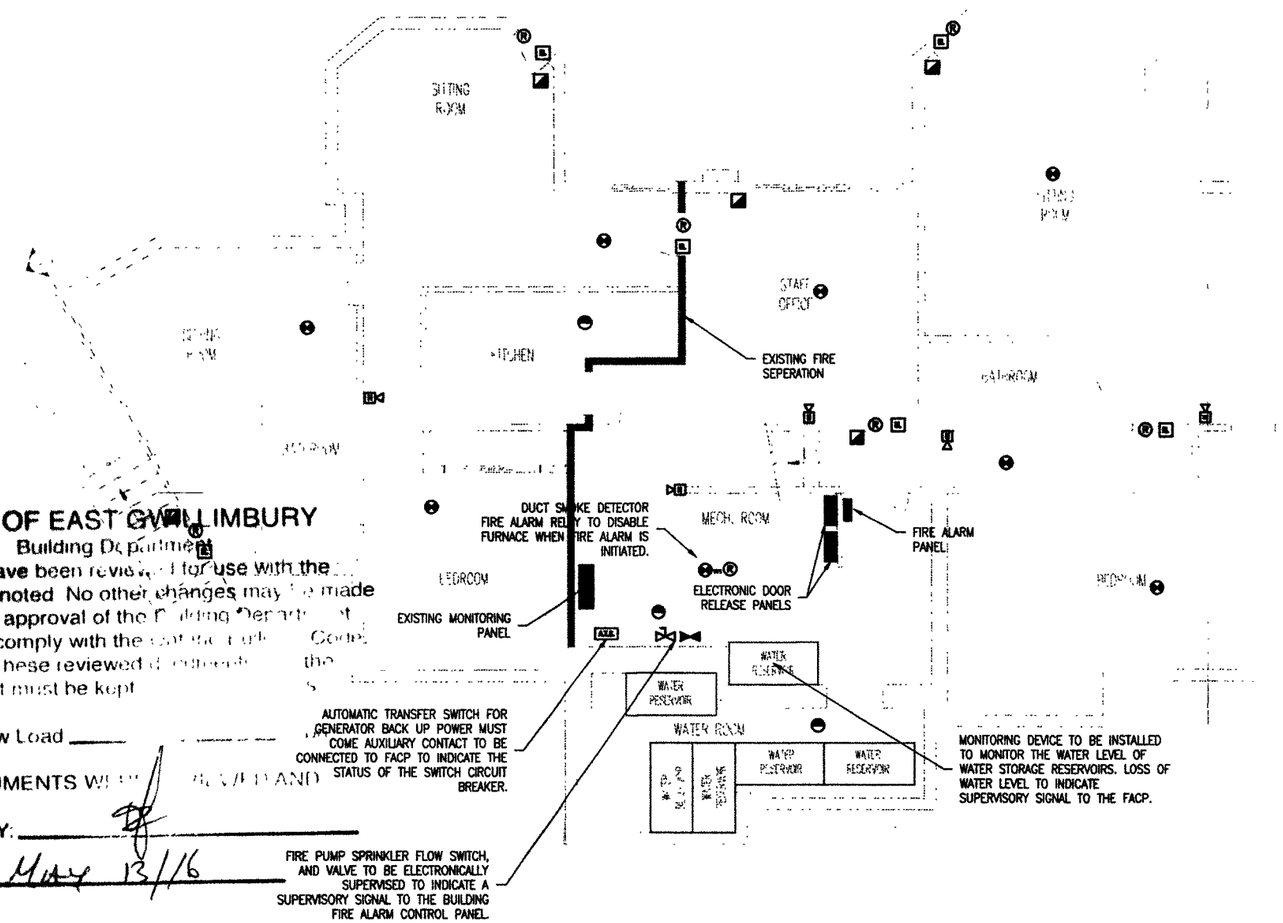

1 BASEMENT LAYOUT
NTS

TOWN OF EAST GWILLIMBURY
Building Department
These plans have been reviewed for use with the corrections as noted. No other changes may be made without written approval of the Building Department. All work must comply with the Ontario Building Code as amended. These reviewed drawings must be kept on the Building Permit site.

Specified Snow Load _____

THESE DOCUMENTS WERE REVIEWED AND

EXAMINED BY: _____

DATE: May 13/16

- ALL ELECTRIC STRIKE LOCKS AND MAG LOCK DEVICES TO BE FAIL SAFE, MEANING IF ELECTRICAL POWER IS DISRUPTED, THE DEVICE WILL AUTOMATICALLY OPEN.

- ALL ELECTROMAGNETIC LOCK DEVICES TO HAVE EMERGENCY BACK UP POWER INSTALLED TO MAINTAIN POWER AND ACCESSIBILITY TO AREAS SECURED WITH ELECTROMAGNETIC LOCKS.

- ALL ELECTROMAGNETIC LOCKS TO BE CONNECTED TO A FIRE ALARM RELAY CONNECTED AND CONTROLLED BY THE FIRE ALARM PANEL. IN THE EVENT OF LOSS OF POWER TO THE FIRE ALARM PANEL ALL ELECTROMAGNETIC LOCKING MECHANISMS MUST RELEASE IMMEDIATELY.

- IN THE EVENT OF AN ALARM SIGNAL, ALL ELECTROMAGNETIC LOCKS WILL RELEASE IMMEDIATELY.

- IN THE EVENT OF A DETECTED FAULT IN THE ELECTRICAL CIRCUIT BETWEEN THE FIRE ALARM AND THE FIRE ALARM CONTROL PANEL, THE DEVICE WILL RELEASE IMMEDIATELY.

- ALL EXISTING FIRE ALARM DEVICES TO BE CONNECTED AND MONITORED THROUGH THE NEW FIRE ALARM PANEL.

- CONTRACTOR TO COORDINATE AND ADHERE TO CLIENTS REQUIREMENTS.

- HORN AUDIBILITY IN ALL BEDROOMS MUST BE A MINIMUM OF 75dBA IN ALL FOUR CORNERS OF THE ROOM.

EME Engineering Inc, Barrie, Ontario
231 Bayview Dr., Unit L101 L4N1W5
EME ENGINEERING
ELECTRICAL MECHANICAL ENERGY

CLIENT
Kerry's Place Autism Services
Services en autisme

PRIME CONSULTANT

STAMP
LICENSED PROFESSIONAL ENGINEER
C. J. LANGFORD
100114456
MAY 4 2016
PROVINCE OF ONTARIO

Drafted by: A.Rozstawski	Date 06/10/2015
Design by: A.Rozstawski	Date 06/10/2015
Checked by: C.Langford	Date 05/03/2016

No.	Revision/Issue	Date
1	Issued for Client Review	06/10/15
2	Issued for Client Review	06/15/15
3	Issued for Permit	07/08/15
4	As-Built as per Contractor	05/03/16

Project title/info
KERRY'S PLACE
3820 DOANE RD.
MOUNT ALBERT, ON

EME PROJ. #20150139

Drawing Title
BASEMENT AND SECOND FLOOR LAYOUT

Project Name: Kerry's Place	Drawing # E.02
Date: 06/10/2015	
Scale: NTS	